


AS BUILT DRAWING

 TAG. NO: AMC-101

TITLE: CONTROL PANEL DRAWING			Neogen Ionics Limited					R3	
PROJECT: 4 DRUM STEAM HEATING HOT BOX			DRN	GAURAV	23/5/25.	DRAWING NO.	SCALE		
R3	05/01/26	AS BUILT DRAWING	CHKD.	ROYSTON	07/08/25	CE07082025	REF.		
R2	05/11/25	MAIN INCOMMER CHANGED TO MPCB MODEL CHANGE AND BLR CHANGED	APPD.				SHEET	1 of 2	
R1	31/10/25	MAIN INCOMMER CHANGED TO MPCB							
REV.NO.	DATE	REVISIONS	CELSUN ECOENERGY & INFRATECH HOLDINGS PVT LTD 157 B ORM ROYAL PALMS GOREGOAN EAST MUMBAI 400065						

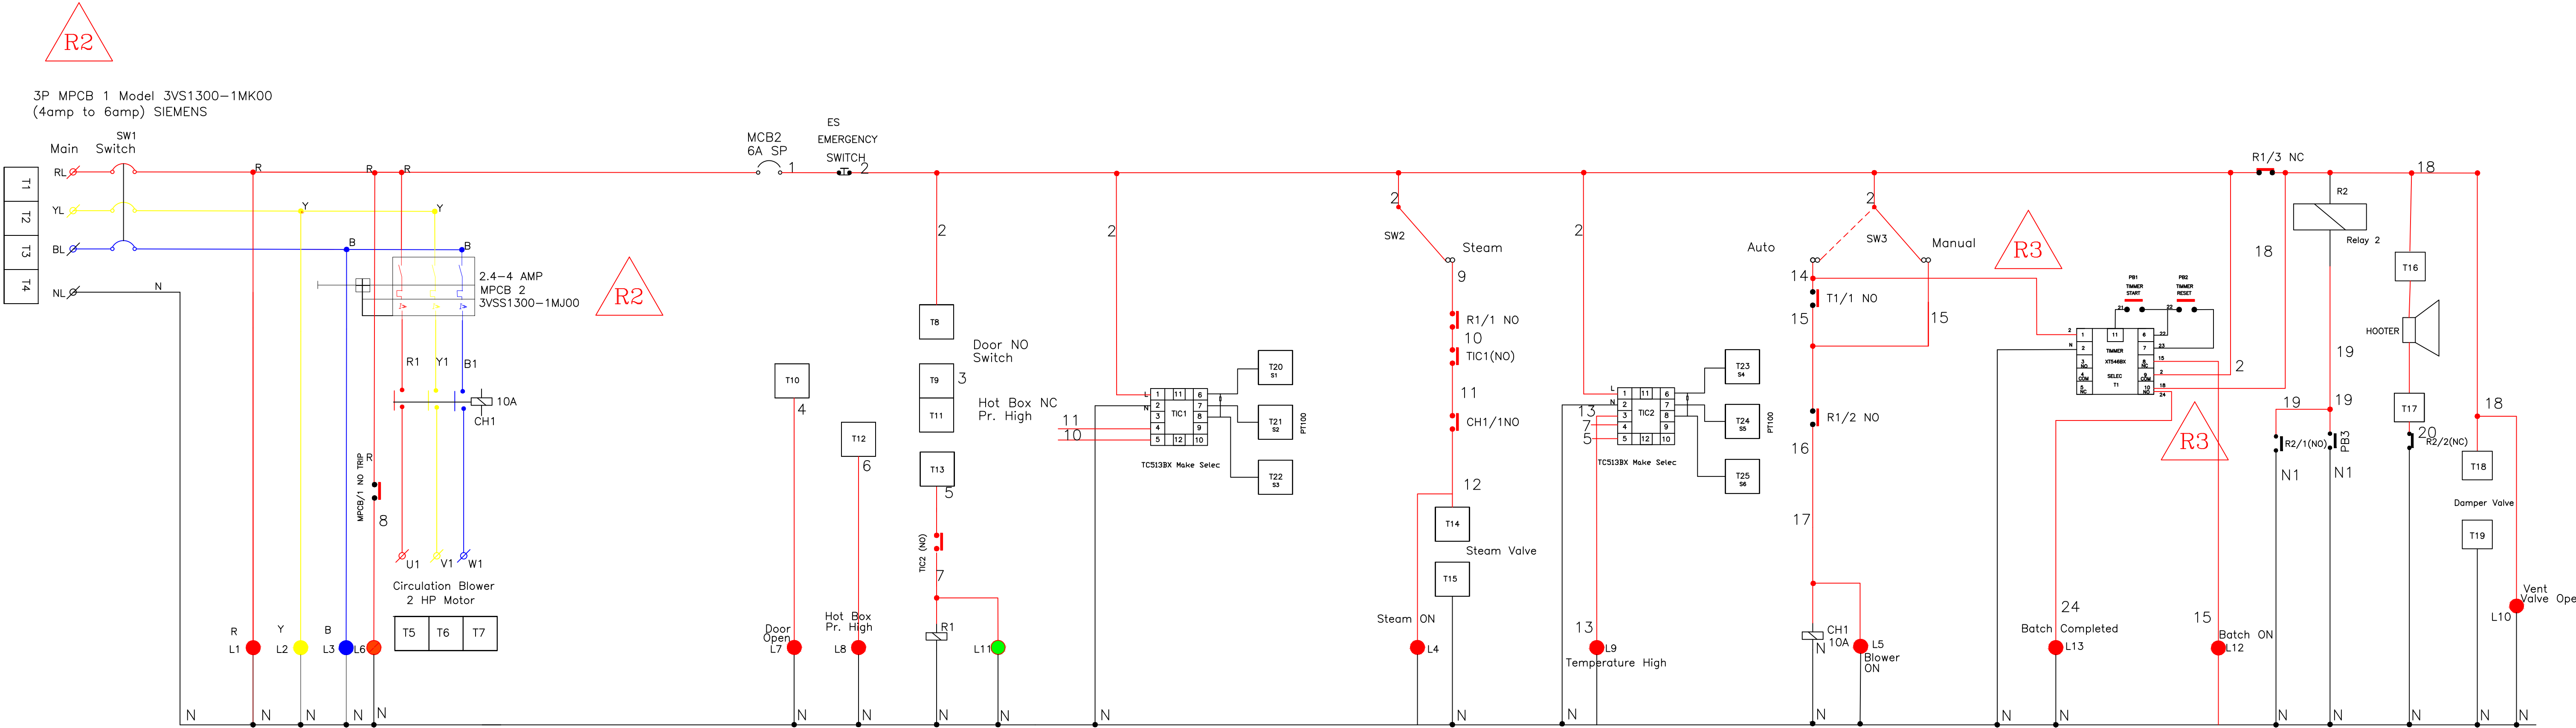

AS BUILT DRAWING

				Blower 1			COM	NO	NC	Pr. Switch			Steam		Hooter		Damper Valve		RTD1			RTD2					
RL	YL	BL	NL	U1	V1	W1	2	3	4	3	6	5	12	N	18	20	18	N	S1	S2	S3	S4	S5	S6	Spare		
T1	T2	T3	T4	T5	T6	T7	T8	T9	T10	T11	T12	T13	T14	T15	T16	T17	T18	T19	T20	T21	T22	T23	T24	T25	T26	T27	T28
Main Incoming 4C x 6mm ² Cu Cable				3C x 1.5mm ² Cu			3C x 1.5mm ² Cu												shielded cable 3C x 1.5mm ² Cu								

R1 TAG. NO: AMC-101

Purchase Order :4500010180 Order Date 10.05.2025

CLIENT: Neogen Ionics Limited
Moje - Pakhajan, Vagra
Bharuch - 392165, Gujarat,
India

TITLE: CONTROL PANEL DRAWING

Neogen Ionics Limited

R3

PROJECT: 4 DRUM STEAM HEATING HOT BOX

DRN GAURAV 23/5/25.

DRAWING NO.

SCALE

R3 05/01/26 AS BUILT DRAWING

CHKD. ROYSTON

CE07082025

REF. SHEET

2 of 2

R2 05/11/25 MAIN INCOMMER CHANGED TO MPCB MODEL CHANGE AND BLR CHANGED

APPD.

R1 31/10/25 MAIN INCOMMER CHANGED TO MPCB

CELSUN ECOENERGY & INFRATECH HOLDINGS PVT LTD

REV.NO. DATE REVISIONS

157 B ORM ROYAL PALMS GOREGOAN EAST MUMBAI 400065